


2ND FLOOR - 3,441 SF

HEARTLAND CENTRE I, FORT SASKATCHEWAN, AB

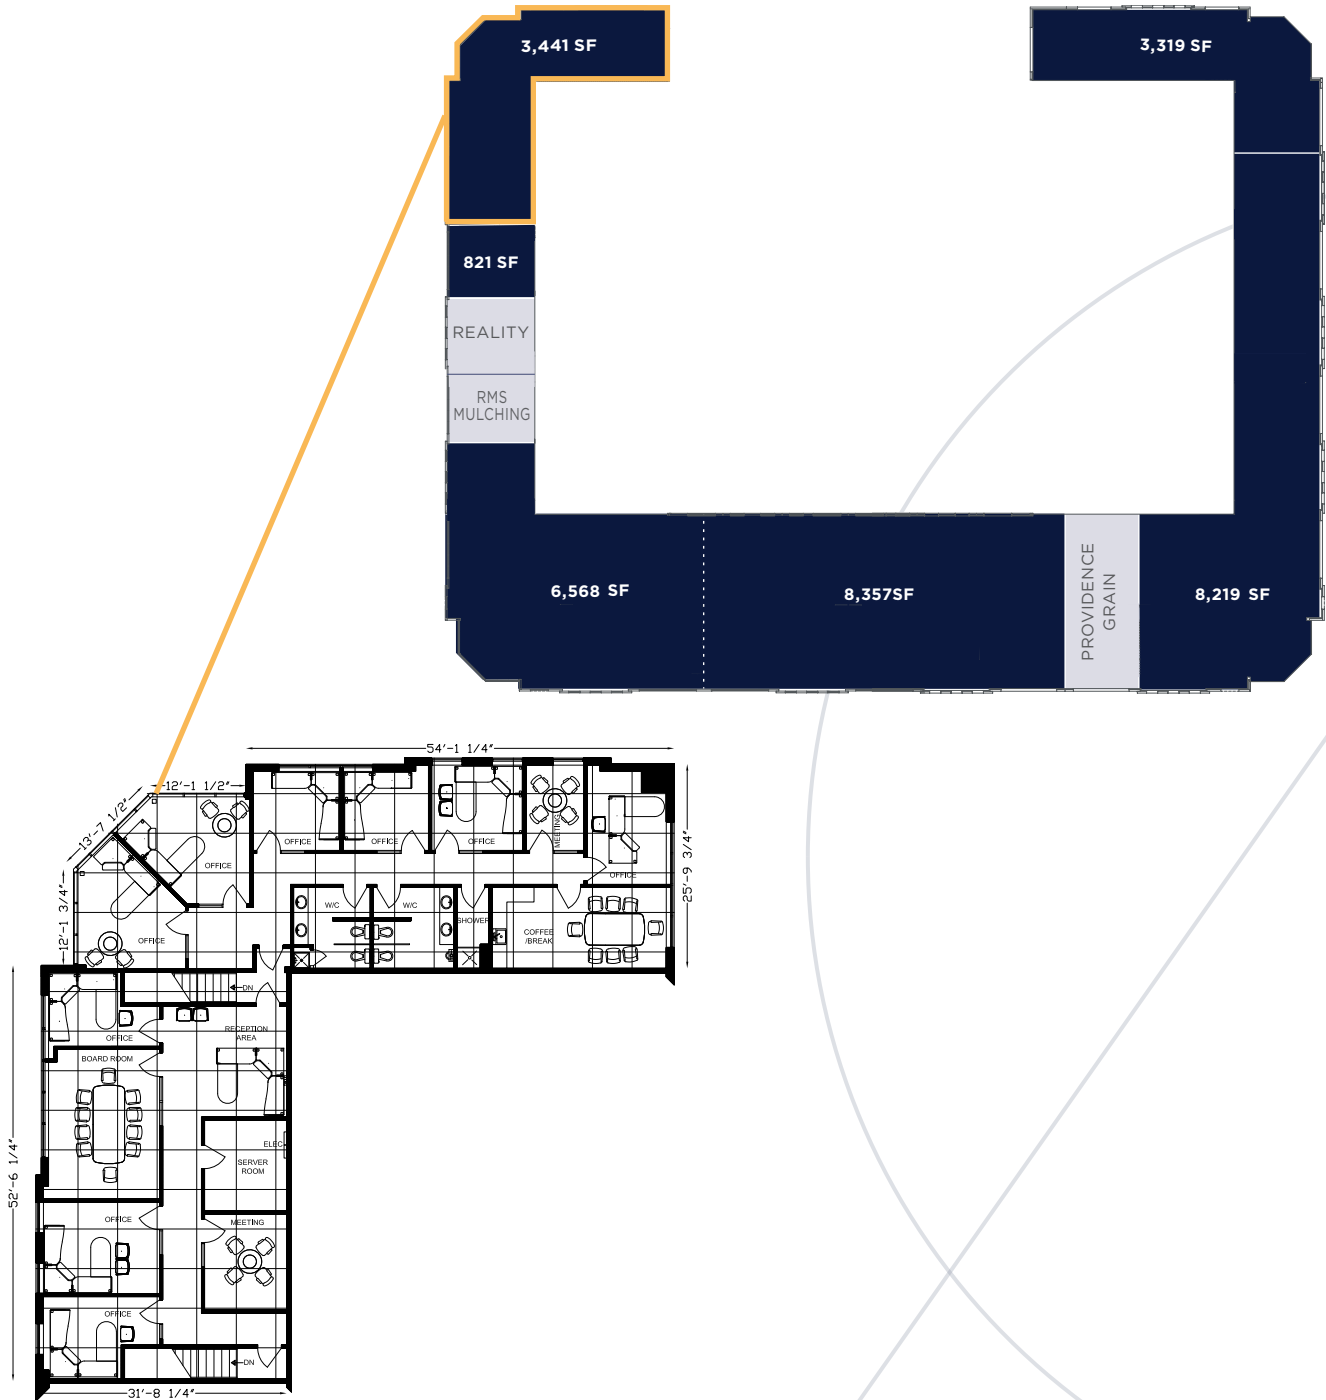

SECOND FLOOR

As Built Plan, 5'x5' Design Grid